

**Ref No.: BD-CW-SAMCO-ACE-LET-STR-063**

**31- March- 2026**

**To:** ACE Project Management | Moharram Bakhoun

**Attention:** Eng. Abdulaziz Mohamed (Project Manager)

**Project Name:** The Big Business District.

**Contract/Package:** Construction Works of the Civil Works for Buildings B1, B2, B3 and B4 – Phase 1.

**Subject:** Comparison of the design issued on 18/03/2026 with the previous design issued on 27/10/2025.

**Dear Sir,**

Following a preliminary comparison between the design drawings issued on 27/10/2025—which were used to approve and execute the shop drawings for the following structural elements:

(foundations for all buildings B1, B2, B3, B4) – (columns up to the last floor) – (retaining walls) – (stairs and cores up to the last floor) – (basement slab: concrete dimensions + reinforcement) – (ground floor slab: concrete dimensions + reinforcement),

and based on which the foundations of all buildings and column starters were executed—and the design drawings received on 18/03/2026 after execution of the above elements, the following has been observed:

**First:**

There are no markings indicating the revisions or modifications in the new design drawings issued on 2026/03/18.

Based on what we were able to verify carried out (for example but not limited to), the following was noted:

**1) Differences in grid and column layout drawings**

The project grid and column layout differ from the previously issued and approved drawings, which were executed accordingly. This affects the raft foundation and other related structural elements. For example:

**First: Columns of Building B1**

- Column (B01-C1) was executed with a width of 600 mm, Meanwhile, in the new design 650 mm
- Column (B01-C3) was executed with a width of 800 mm, Meanwhile, in the new design 850 mm
- Column (B01-C4) was executed with a width of 700 mm, Meanwhile, in the new design 800 mm

**Second: Columns of Building B2**

- Column (B02-C3) was executed with a width of 600 mm, Meanwhile, in the new design 650 mm
- Columns (C4, C5, C6): differences in column locations were found due to grid modifications

**Third: Columns of Building B3**

- Column (B03-C3) was executed with a width of 500 mm, Meanwhile, in the new design 550 mm
- Column (B03-C2): difference in location due to grid changes

**Fourth: Columns of Building B4**

- Column (B04-C1) was executed with a width of 600 mm, Meanwhile, in the new design 650 mm
- Column (B04-C5) was executed with a width of 700 mm, Meanwhile, in the new design 750 mm



**Fifth:**

Differences were found in grid locations (23–21') compared to the approved design, for which an RFI had previously been issued and officially approved:  
Attachment: BD-CW-SAMCO-PCO-RFI-STR-002-R01

We kindly request that all previously executed and approved works be maintained as approved by your side. Additionally, when issuing any new drawings, please clearly mark or cloud all changes and revisions to facilitate quick comparison and assessment of their impact.

**2) Please clarify the approved Roadmap and which set of drawings should be followed for execution, as issuing new drawings that impact the critical path will affect the project duration due to the resulting changes.**

We kindly request your prompt response and clarification.

**With sincere regards and appreciation,**

**Eng./ Mohammed Sami Mohammed  
Project Director  
SAMCO National Construction**



**Ref No.: BD-CW-SAMCO-ACE-LET-STR-063**

**31- March- 2026**

**To:** ACE Project Management | Moharram Bakhoun

**Attention:** Eng. Abdulaziz Mohamed (Project Manager)

**Project Name:** The Big Business District.

**Contract/Package:** Construction Works of the Civil Works for Buildings B1, B2, B3 and B4 – Phase 1.

**Subject:** Comparison of the design issued on 18/03/2026 with the previous design issued on 27/10/2025.

**Dear Sir,**

Following a preliminary comparison between the design drawings issued on 27/10/2025—which were used to approve and execute the shop drawings for the following structural elements:

(foundations for all buildings B1, B2, B3, B4) – (columns up to the last floor) – (retaining walls) – (stairs and cores up to the last floor) – (basement slab: concrete dimensions + reinforcement) – (ground floor slab: concrete dimensions + reinforcement),

and based on which the foundations of all buildings and column starters were executed—and the design drawings received on 18/03/2026 after execution of the above elements, the following has been observed:

**First:**

There are no markings indicating the revisions or modifications in the new design drawings issued on 2026/03/18.

Based on what we were able to verify carried out (for example but not limited to), the following was noted:

**1) Differences in grid and column layout drawings**

The project grid and column layout differ from the previously issued and approved drawings, which were executed accordingly. This affects the raft foundation and other related structural elements. For example:

**First: Columns of Building B1**

- Column (B01-C1) was executed with a width of 600 mm, Meanwhile, in the new design 650 mm
- Column (B01-C3) was executed with a width of 800 mm, Meanwhile, in the new design 850 mm
- Column (B01-C4) was executed with a width of 700 mm, Meanwhile, in the new design 800 mm

**Second: Columns of Building B2**

- Column (B02-C3) was executed with a width of 600 mm, Meanwhile, in the new design 650 mm
- Columns (C4, C5, C6): differences in column locations were found due to grid modifications

**Third: Columns of Building B3**

- Column (B03-C3) was executed with a width of 500 mm, Meanwhile, in the new design 550 mm
- Column (B03-C2): difference in location due to grid changes

**Fourth: Columns of Building B4**

- Column (B04-C1) was executed with a width of 600 mm, Meanwhile, in the new design 650 mm
- Column (B04-C5) was executed with a width of 700 mm, Meanwhile, in the new design 750 mm

**SAMCO National Construction Co.**  
76 Al Taya ran St, Nasr City, Cairo, Egypt  
Tel: 02 226 245 27  
Tel: 02 238 688 16

---



**Fifth:**

Differences were found in grid locations (23–21') compared to the approved design, for which an RFI had previously been issued and officially approved:  
Attachment: BD-CW-SAMCO-PCO-RFI-STR-002-R01

We kindly request that all previously executed and approved works be maintained as approved by your side. Additionally, when issuing any new drawings, please clearly mark or cloud all changes and revisions to facilitate quick comparison and assessment of their impact.

**2) Please clarify the approved Roadmap and which set of drawings should be followed for execution, as issuing new drawings that impact the critical path will affect the project duration due to the resulting changes.**

We kindly request your prompt response and clarification.

**With sincere regards and appreciation,**

**Eng./ Mohammed Sami Mohammed**  
**Project Director**  
**SAMCO National Construction**





The Big

Request for Information (RFI)

|                  |                             |  |          |                             |
|------------------|-----------------------------|--|----------|-----------------------------|
| Project:         | The Big Business District   |  | RFI No : | BD-CW-SAMCO-PCO-RFI-STR-002 |
| Owner:           | ROYA Developments           |  | Rev. :   | R01                         |
| Project Manager: | ACE-PM                      |  | Date :   | 08 / 12 / 2025              |
| Consultant:      | Prime Consultant            |  |          |                             |
| Contractor:      | SAMCO National Construction |  |          |                             |
| To:              | PCO                         |  |          |                             |

Subject

Conflict between the general layout plan and the approved structural drawings.

after reviewing the Latest Coordination Design Revision dated 27/10/2025, and the approved structural shop drawing AMCO-PCO-SHD-STR-001, and comparing them with the Setting Out Plan, a grid line discrepancy has been identified as follows:

- \* An offset in Grid Line 23' of 8 cm.
- \* A location discrepancy in Grid Line 21 compared to the approved structural grid system.

approved structural grids.

Accordingly, please note that we has revised the Setting Out Drawing and realigned all grid lines to match the approved structural drawings. The updated drawing is attached for your review and approval.

Attachments: **--SETTING OUT BASED ON STRUCTURAL DESIGN AXES--**

For Contractor:

Signature :

Date:

Supervision Consultant Response:

For the offset grid line 23', Please refer ro the reply on the submittl # BD-CW-SAMCO-PCO-RFI-STR-002 Rev 00 dated on 27/09/2025 & replied by consultant on 2/10/2025

For Grid Line 21', Please stick to drawing No. (SI000-COLUMN AND AXIS -OVERALL) issued via Strucure package on 27/10/2025

RE:

Signature :

Date: 21/12/2025

Project Manager Response (If required)

ACEPM:

Signature

Date:

Distribution

CC :

ACEPM

This is not a Variation document. If the Contractor considers any part of the above response a variation to its cost or time of performance, the Contractor is required to give notice in accordance with the Conditions of Contract



1. NO DIMENSIONAL INFORMATION IS TO BE OBTAINED BY SCALING FROM DRAWING; ONLY WRITTEN DIMENSION SHOULD BE FOLLOWED.
2. ALL DIMENSIONS ARE IN MILLIMETERS AND ALL LEVEL ARE IN METERS UNLESS NOTED OTHERWISE.
3. CONCRETE CHARACTERISTICS COMPRESSIVE STRENGTH AS 28 DAYS IS 35 MPa.
4. MAIN REINFORCEMENT IS HIGH TENSILE OF A MINIMUM YIELD STRENGTH 500 MPa.
5. CONCRETE COVER SHALL BE AS FOLLOWS:
  - FOUNDATION 50mm
  - BEAMS 30mm
  - WALLS 30mm
  - SLABS 25mm
6. FOR GENERAL NOTES AND STANDARD DETAILS REFER TO DWG 50001, 50002, 50003, 50004, 50004.

1. NO DIMENSIONAL INFORMATION IS TO BE OBTAINED BY SCALING FROM DRAWING; ONLY WRITTEN DIMENSION SHOULD BE FOLLOWED.
2. ALL DIMENSIONS ARE IN MILLIMETERS AND ALL LEVEL ARE IN METERS UNLESS NOTED OTHERWISE.
3. CONCRETE CHARACTERISTICS COMPRESSIVE STRENGTH AS 28 DAYS IS 35 MPa.
4. MAIN REINFORCEMENT IS HIGH TENSILE OF A MINIMUM YIELD STRENGTH 500 MPa.
5. CONCRETE COVER SHALL BE AS FOLLOWS:
  - FOUNDATION 50mm
  - BEAMS 30mm
  - WALLS 30mm
  - SLABS 25mm
6. FOR GENERAL NOTES AND STANDARD DETAILS REFER TO DWG 50001, 50002, 50003, 50004, 50004.

|          |      |
|----------|------|
| - SLABS  | 25mm |
| <b>G</b> |      |

6. FOR GENERAL NOTES AND STANDERD DETAILS REFER TO DWG S0001, S0002, S0003, & S0004.

---

- 

[illegible]

## THE BIG BUSINESS DISTRICT

## New Calro, Calro

ROYA DEVELOPMENTS

311150 corrected and of herring breeding, St. Petersburg  
1915, 1916

**MAIN CONSULTANT**

100-14 Nordströmstr., 14. Stockholms  
PRIME CONSULTING OFFICE

Tel: +2 021 230 860 039  
www.poc-mg.net

**STRUCTURE CONSULTANT**

2 Saeed Zakaria St., Suwaydah, Near City,  
Cairo, Egypt

Tel: (202) 2399066 + 20100803422  
info@asplu.net

**PRECISION CONSULTING  
ENGINEERING**

39 Bahi St., Dokki, CA, Egypt

www.elsevier.com

| PLANT | DATE  | SCALE   |
|-------|-------|---------|
| A-T   | MARCH | 1 : 100 |

|                      |     |
|----------------------|-----|
| 100% DETAILED DESIGN | M.A |
|----------------------|-----|


| BUILDING NAME |
|---------------|
|               |

|                                |      |
|--------------------------------|------|
| DRAWING TITLE:                 | REV. |
|                                |      |
| COLUMBIA AND AVE. LAYOUT-DRAFT |      |

| COLUMNS AND AXES LATITUDE-PARIZ | D |
|---------------------------------|---|
|---------------------------------|---|


|       |  |
|-------|--|
| 70076 |  |
|-------|--|

---

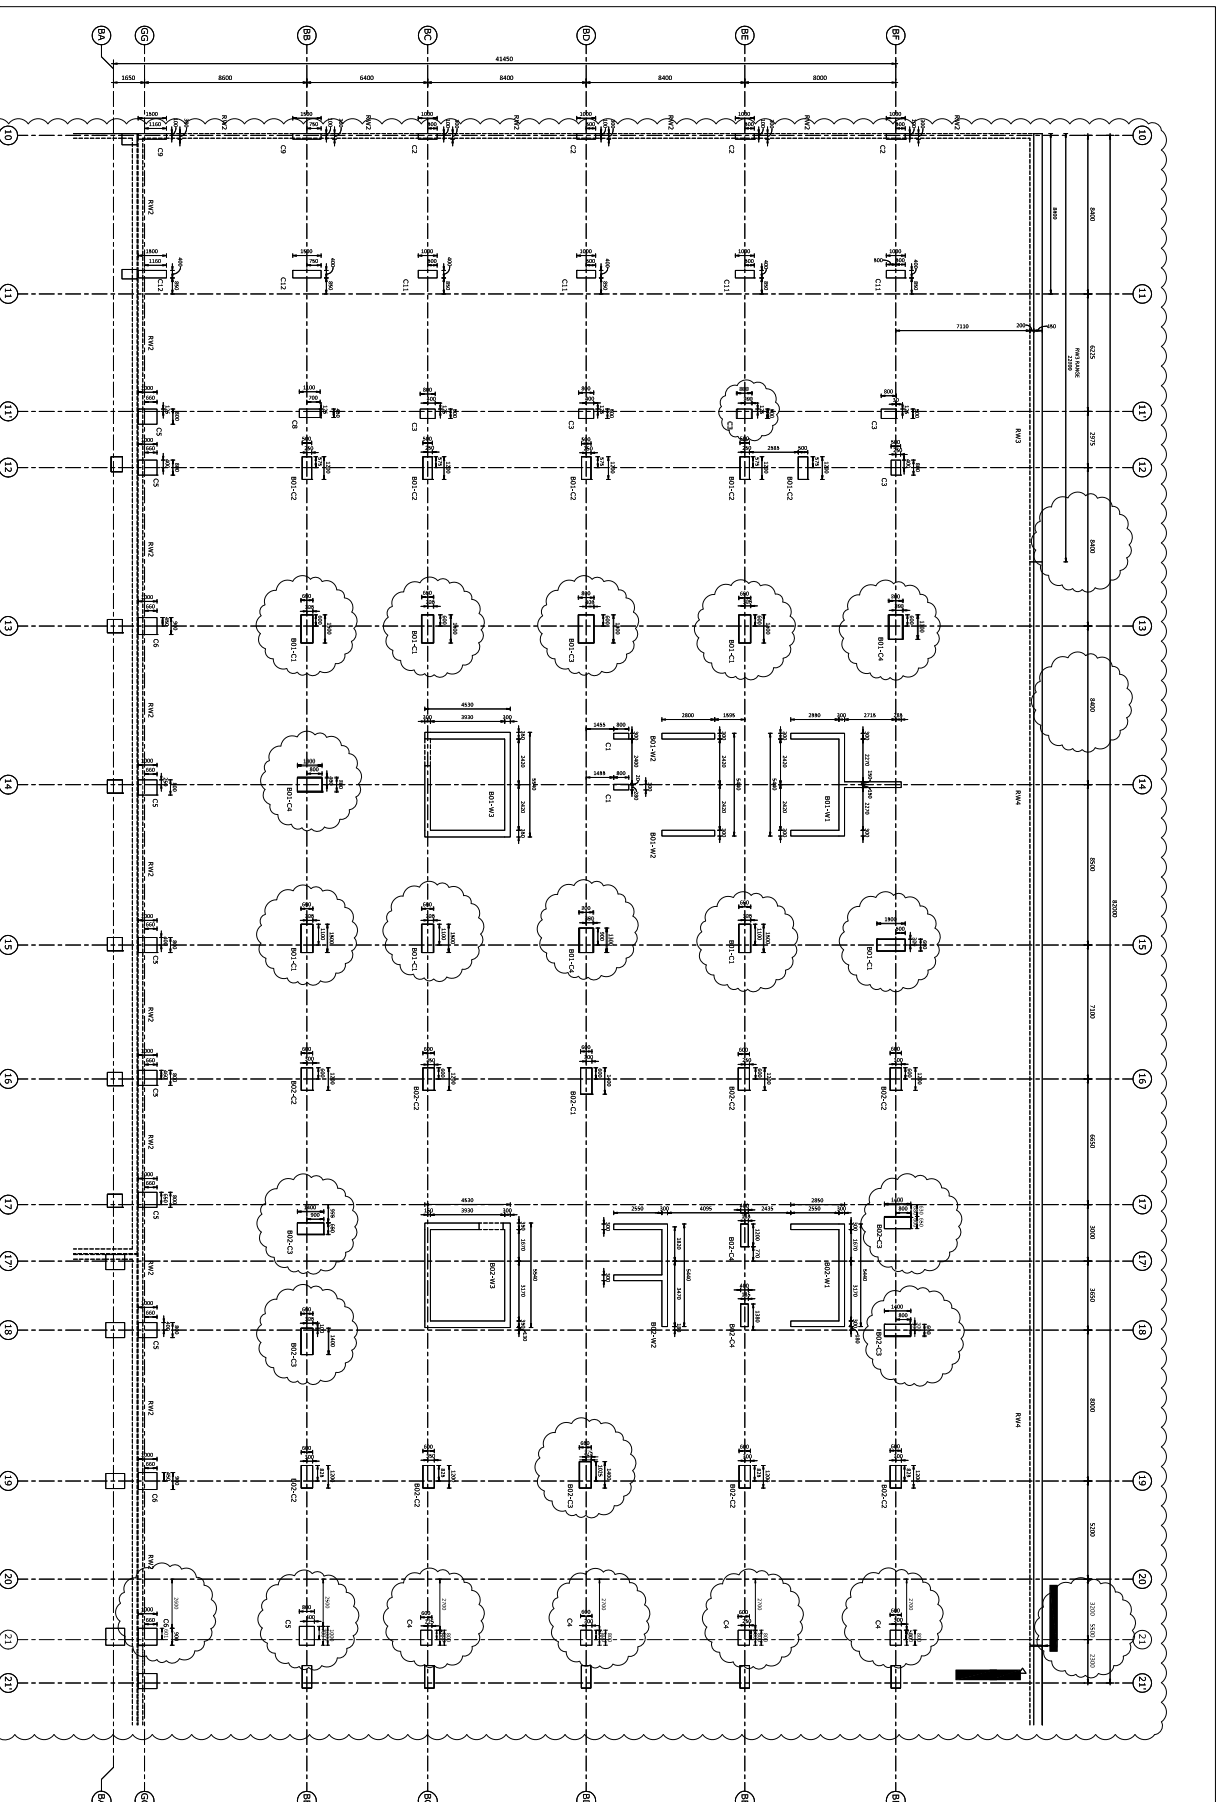



1. NO DIMENSIONAL INFORMATION BE OBTAINED BY SCALING FROM DRAWINGS. ONLY WRITTEN DIMENSION SHOULD BE FOLLOWED.
2. ALL DIMENSIONS ARE IN MILLIMETERS AND ALL LEVEL ARE IN METERS UNLESS NOTED OTHERWISE.
3. CONTRACT CHARACTERISTIC COMPRESSIVE STRENGTH IS 28 DAYS IS 35 MPa.
4. MAIN REINFORCEMENT IS HIGH TENSILE OF A MINIMUM YIELD STRENGTH 500 MPa.
5. CONTRACT COVER SHALL BE AS FOLLOWS:
  - FLOOR/SLAB 50mm
  - BEAMS 50mm
  - WALLS 30mm
  - SLABS 25mm
6. FOR GENERAL NOTES AND STANDARD DETAILS REFER TO GCN 50001, 50002 & 50003.

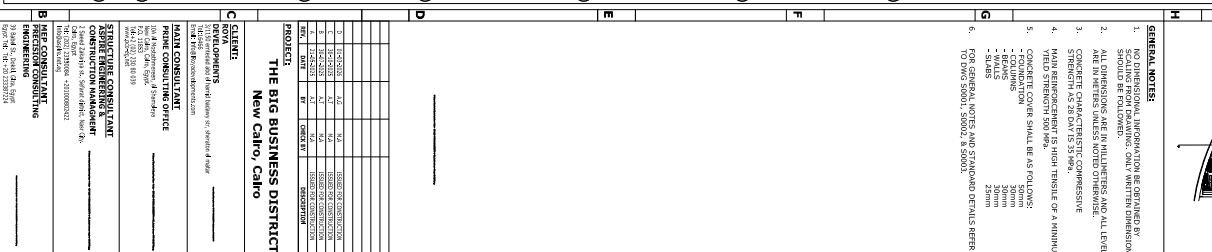

## COLUMNS AND AXES LAYOUT-PART 1

|                               |                     |             |
|-------------------------------|---------------------|-------------|
| DESIGNED BY                   | DATE                | SCALE       |
| AJT                           | MARCH               | 1 : 100     |
| SHEET                         |                     | APPROVED BY |
| 100% DETAILED DESIGN          |                     | M.A         |
| BUILDING NAME                 | PARCEL 02           |             |
|                               | 801, 802, 803 & 804 |             |
| DRAWING TITLE:                |                     | REV.        |
| COLUMNS AND AXES LAYOUT-PART1 |                     | D           |